


NOTE:
UNDERGROUND FACILITIES, STRUCTURES AND UTILITIES
HAVE BEEN PLOTTED FROM AVAILABLE SURVEYS AND
RECORDS, AND THEREFORE THEIR LOCATIONS MUST BE
CONSIDERED APPROXIMATE ONLY. THERE MAY BE
OTHERS, THE EXISTENCE OF WHICH IS PRESENTLY NOT
KNOWN.

GMH-1 (STA. 0+00)
(SEE SH.10)


GMH-2
(SEE SH.10)

MH-2

48" - BYPASS DETAIL
NOT TO SCALE

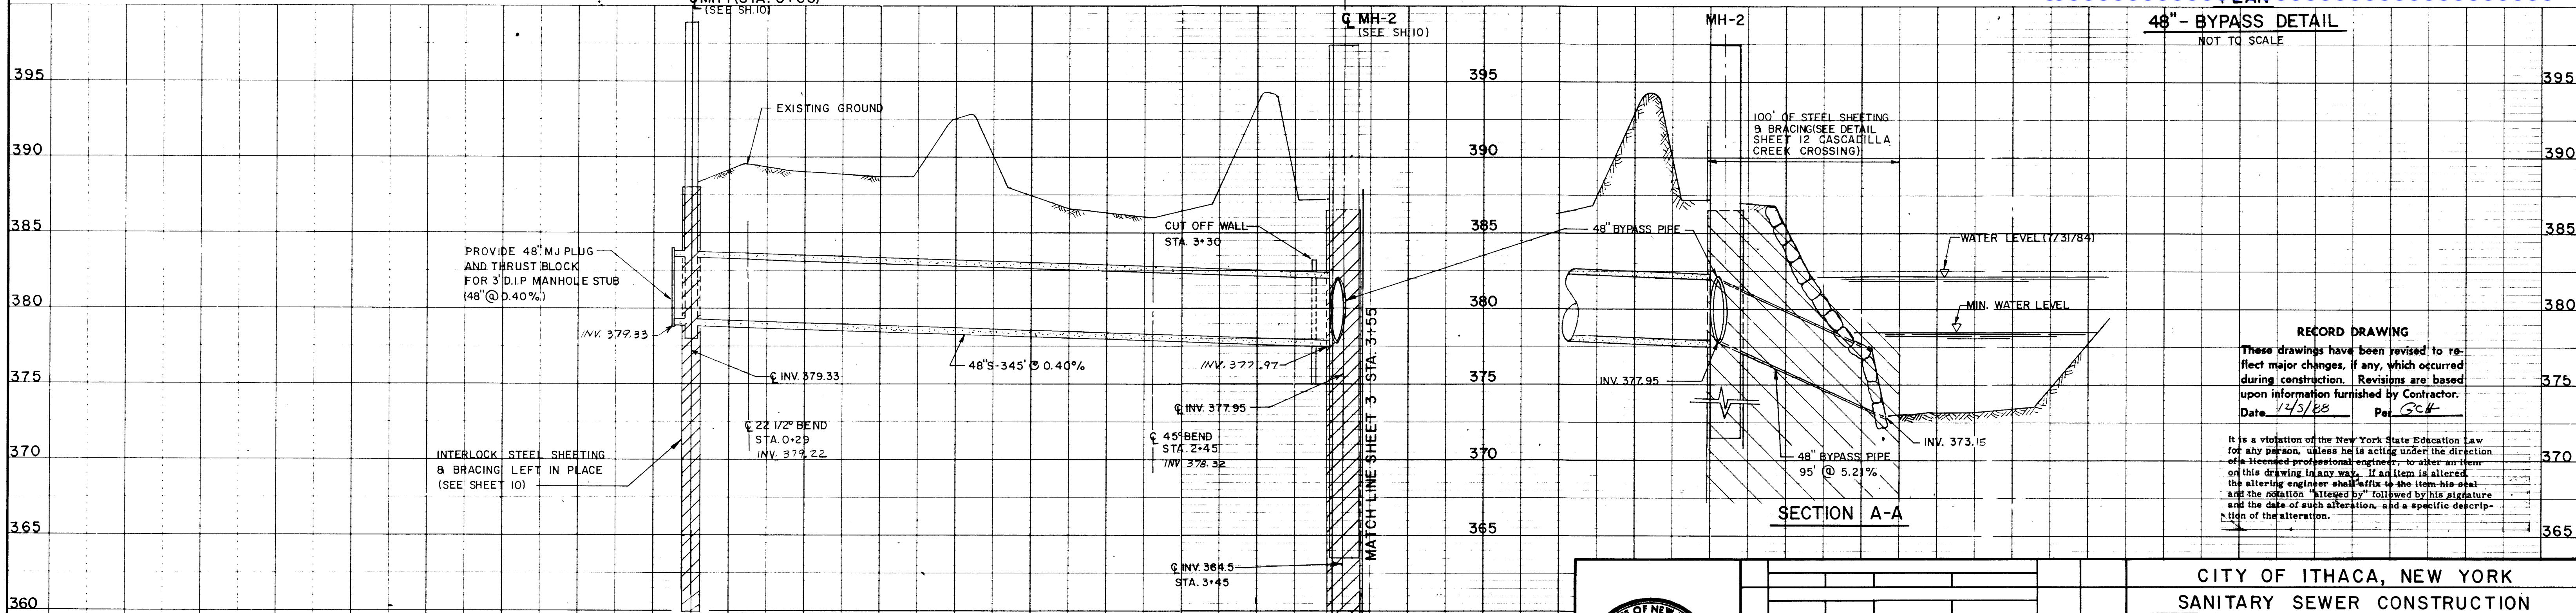

RECORD DRAWING
These drawings have been revised to reflect major changes, if any, which occurred during construction. Revisions are based upon information furnished by Contractor.
Date 4/5/88 Per GCH
It is a violation of the New York State Education Law for any person, unless he is acting under the direction of a licensed professional engineer, to alter any item on this drawing in any way. If an item is altered, the altering engineer shall affix to the item his seal and the notation "Altered by" followed by his signature and the date of such alteration, and a specific description of the alteration.

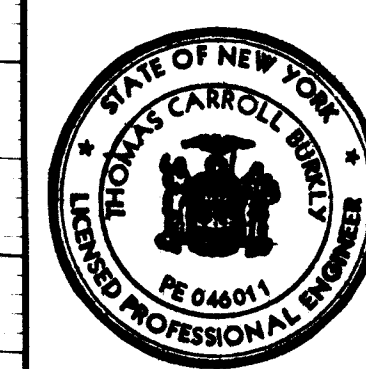

NO.	DATE	DESCRIPTION	DESIGNER	CHECKED	APPROVED
2	8/84	APPROVED FOR CONSTRUCTION	RWE		TCP
1	3/82	FOR APPROVALS	WJG		TCI

PROJECT SUPERVISOR: *Lawrence O. Deley* APPROVED: *Brill*

CITY OF ITHACA, NEW YORK
SANITARY SEWER CONSTRUCTION

48" OUTFALL TO LAKE

Stearns & Wheeler
CIVIL AND SANITARY ENGINEERS

CAZENOVIA, NEW YORK NEW CANAAN, CONNECTICUT